



CITY OF CONCORD

Code Administration

37 Green Street • Concord, New Hampshire 03301 • 225.8580 • Fax 225.8586

ZBA APPROVAL OF LOCATION
GRANTED 5/11/21, CASE 26-21
MONUMENT - ITEM A

APPLICATION TO ERECT A SIGN

Permit # _____

1) Address where sign is to be erected:

190 NORTH MAIN ST

2)

Message as shown on sign:

NORTHWAY BANK

RECEIVED

MAY 13 2021

3) CODE ADMINISTRATION

Property Owner Information

Sign Installer Information

Sign Owner Information

Name >

R&H LEASING INC

BARLO SIGNS

NORTHWAY BANK

Address >

42 WASHINGTON ST

18 HAVERHILL ST

190 N MAIN ST

City/State/ Zip >

PENACOOK NH 03303

HUDSON NH 03051

CONCORD NH 03301

Phone(s) >

731 6135

603 966 6078

E-mail >

jenn@barlosigns.com

4) Property Information:

CU

Zone

120

Store/Building Frontage

ft

209

Lot Frontage

ft

5)

☒ New

☐ Relocation

☐ Replacement

Type of Sign:

☒ Freestanding

☐ Monument

☐ Wall

☐ Projecting

☐ Window

☐ Awning

☐ Roof

☐ Marquee

☐ Marker

5) Materials to be used:

BEA PLEXI STEEL

6) How & to what is sign supported:

STEEL POLE

7) Dimensions of sign:

3'9

ft x

6'11

ft

equals

27

sf

Length

Height

Total (Round up)

8) Height Overall:

Ground to bottom of sign

3'

ft

Ground to top of sign

6'9

ft

9) Illumination:

☐ None

☐ External

☒ Internal

Internally illuminated signs are **NOT** permitted in CVP, IS, UT or any Residential Zones

10) Does sign project over public property or sidewalk?

☒ No

☐ Yes* > *

ft

in

11)

How far back is leading edge of sign from any curb face?

8+'

NOTE: Any applicant for a permit to locate a projecting sign over a public right-of-way, in accordance with this Ordinance, shall file with the Code Administrator, a certificate of insurance indemnifying the City of Concord against any form of liability in a minimum amount as specified by the Finance Director. No permit shall be issued prior to the receipt of said certificate and the permit shall be valid only so long as the certificate remains in effect. The policy shall provide for advance notification to the Code Administrator in the event of cancellation. If the policy should lapse or be cancelled, the applicant shall remove the sign immediately. (Article 28-6-11.a)

12) Does the sign require Design Review?

☒ *Yes

☐ No

Historic District Review?


☐ Yes

☒ No

*Design review is **required** per Article 28-6-9.f, if any of the following apply:

- I. The sign is to be located in a Performance (P) District
- II. The Development requires Major Site Plan Review, Article 28-9-4.d.1
- III. The sign area is greater than the maximum in Column 1 of Table 28-6-9.a
- IV. The sign is the second or third freestanding sign on a lot.

Continued

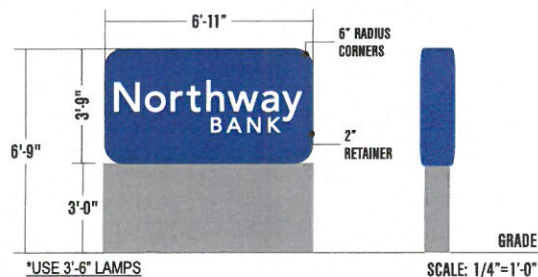

ALL MEASUREMENTS ARE APPROX.
SITE SURVEY REQUIRED

EXISTING SIGN OR BUILDING MEASUREMENTS



SIMULATED NIGHT VIEW

Northway
BANK

SCOPE OF WORK

REMOVE & DISPOSE (2) EXISTING POST

MANUFACTURE & INSTALL (1) D/F LED ILLUMINATED MONUMENT SIGN WITH APPLIED VINYL AND POLE COVER.

USING EXISTING BASE AND STEEL FOR SIGN

TOTAL SQUARE FEET: 27.12 WITH A MIN. OF A 10' SETBACK

CODE ALLOWANCE: 32.6 SQ FT VARIANCE REQUIRED: N/A

COLOR SCHEDULE - CLIENT TO VERIFY

PTM AND VINYL 3630-157 SULTAN BLUE POLE COVER PTM PMS 430C GRAY


MFG. SPECIFICATIONS - CABINET

LED LIT CABINET
CABINET: PTM 3630-157 SULTAN BLUE
FACE: 3/16" WHITE POLYCARBONATE W/
3630-157 SULTAN BLUE APPLIED VINYL
RETAINER: PTM 3630-157 SULTAN BLUE

ILLUMINATION: WHITE LED



INTERNATIONAL
© COPYRIGHT 2019
THIS DESIGN CONCEPT IS THE PROPERTY OF
BARLO SIGNS INTERNATIONAL, INC.

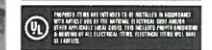

PROJECT APPROVAL
Client: Date:
Design: Date:
Sales: Date:
Updating: Date:
Production: Date:

DESIGNER: AS
SALES REP: BARN
PM: XX

NORTHWAY BANK
190 N. MAIN ST
CONCORD, NH 03301
02.10.21

ITEM
A


SHEET 1.0

SCALE: 1/2"=1'-0"



**ALL MEASUREMENTS ARE APPROX.
SITE SURVEY REQUIRED**

FILE NAME: Northway Bank 210207772 1

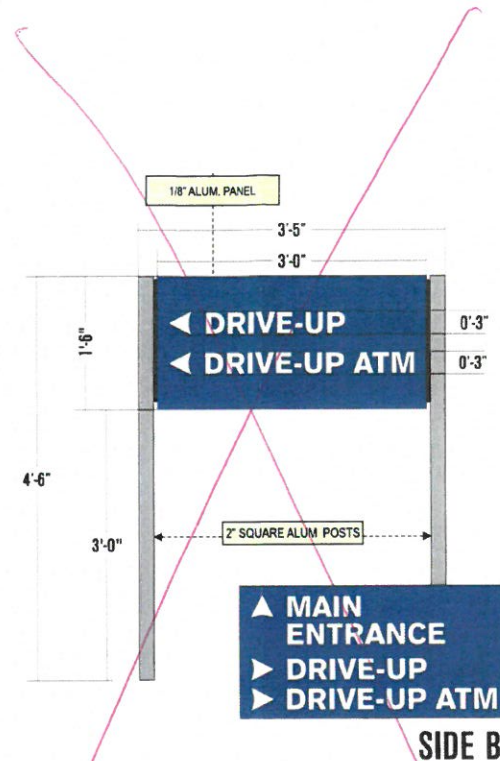

SCALE: 3/4"=1'-0"

SCOPE OF WORK

REMOVE & DISPOSE (2) EXISTING POST

MANUFACTURE & INSTALL (1) D/F NON-ILLUMINATED DIRECTIONAL SIGN WITH (2) POST.

TOTAL SQUARE FEET: 4

CODE ALLOWANCE: SQ FT

VARIANCE REQUIRED: N/A

COLOR SCHEDULE - CLIENT TO VERIFY

PTM 3630-157 SULTAN BLUE

POST PTM
PMS 430C GRAY

☐ REFLECTIVE WHITE
680-10 APPLIED VINYL