


MATERIALS LEGEND

LIMIT OF WORK		
PAVING MATERIALS		
P1	ASPHALT PAVEMENT - PEDESTRIAN	1 1.5-1
P2	ASPHALT PAVEMENT WITH BRICK BORDER	2 1.5-1
P3	POROUS ASPHALT PAVEMENT - VEHICULAR, SEE CIVIL DWGS.	
P3A	STANDARD ASPHALT PAVEMENT - VEHICULAR, SEE CIVIL DWGS.	
P4	GRANITE PAVEMENT	3 6 7 1.5-1 1.5-1 1.5-1
P5	CONCRETE UTILITY PAD	4 1.5-1
WALLS		
W1	STONE WALL - FREESTANDING	1 1.5-1
W2	ADD ALTERNATE STONE TREE WELL	2 1.5-1
SITE IMPROVEMENTS		
S1	DETECTABLE WARNING PAVERS	1 1.5-1
S2	BOLLARD	7 1.5-1
S3	LIGHT POLE FOOTING	6 1.5-1
S4	LANDSCAPE BOULDER	4 1.5-1
S5	MAINTENANCE STRIP	5 1.5-1
S6	RIVER STONE CHANNEL	3 1.5-1
S7	TRENCH DRAIN - NORTH TERRACE	3 1.5-1
S8	SLOT DRAIN - SOUTH TERRACE	2 1.5-1
S9	NORTH ENTRY SIGN, SEE SIGNAGE DRAWINGS	
S10	ADD ALTERNATE BICYCLE SHELTER	9 1.5-1
S11	BICYCLE RACK	8 1.5-1
S12	WASTE BIN ENCLOSURE	1 2 3 4 1.5-1 1.5-1 1.5-1 1.5-1
S13	MECHANICAL ENCLOSURE	2 3 5 6 1 1.5-1 1.5-1 1.5-1 1.5-1
S14	RECLAIMED GRANITE WINDOWSILLS	10 1.5-1

NOTES:
1. REFER TO SHEET 1.5-1 FOR GRANITE PAVING PLAN ENLARGEMENTS
2. REFER TO SHEET 1.5-6 FOR RAIN GARDEN ENLARGEMENT PLAN AND DETAILS

CONSTRUCTION HAS BEEN COMPLETE WITH THE EXCEPTION OF THE FOLLOW ITEMS AS SHOWN ON MARKED UP PLAN.

1 SITE MATERIALS PLAN
SCALE: 1" = 20'-0"

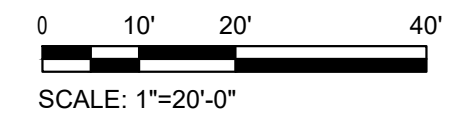

REVISIONS		
#	DATE	DESCRIPTION
1	10/05/2023	BULLETIN #1
2	04/08/2025	BULLETIN #40

FLEISCHNER FAMILY ADMISSION CENTER



St. Paul's School


325 PLEASANT STREET
CONCORD, NH 03301

cbt
One Constitution Road
Suite 200
Boston, MA 02129
cbtarchitects.com
617.262.4354

ARCADIS
21 Custom House St, 3rd Fl
Boston MA 02110 USA
tel 617 896 2500
arcadis.com



CONSTRUCTION DOCUMENTS

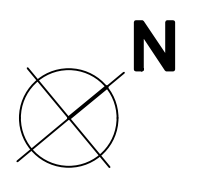

LANDSCAPE MATERIALS PLAN

SCALE 1" = 20'-0" PROJECT # 229008.00 DATE ISSUED 06/30/2023