RECEIVED
SEP 15 2020
CODE ADMINISTRATION

CITY OF CONCORD
CODE ADMINISTRATION
37 GREEN ST CONCORD NEW HAMPSHIRE 03301 225.8580

APPLICATION TO ERECT A SIGN Permit # _____

1. Address where sign is to be erected: Patriots Place 297 Loudon Rd Concord NH
2. Message as shown on sign: JARED / logo JAMES Allen
3. Name & Address of property owner: QEI Capital Corp 30 east seventh st ST PAUL MN 55101
   Phone # 651 225 Khagen@qeifunds.com
4. Name & Address of Sign Owner: Signet Jewelers 375 ghent rd akron OH 44333
   Phone # 330-241 1722 brad-ziegler@signetjewelers.com
5. Name & Address of Sign Installer: Sign Erection & Maintenance 22 maple AVE NEWTON NH 03858
   Phone # 978 609 4123 - Danny dthewes28@gmail.com
6. Property Information: GWP | 101'4" ft | 140' ft
   Zone | Store/Building Frontage | Lot Frontage
7. Type of Sign: ☐ New ☐ Relocation ☑ Replacement ☑ Affixed
   ☐ Awning ☐ Window ☐ Marquee ☐ Hanging
   ☐ Marker ☐ Freestanding ☐ Monument ☐ Roof
8. Materials to be used: Aluminum & lexan
9. How is sign attached/supported: thru bolts through store Front
10. Dimensions of Sign: 12'8" / 10'8" ft x 37" / 18" ft equals 56 sf
    Length | Height | Total (Please Round Up)
11. Height Overall: Ground to bottom of sign ~~30~~ 17 ft Ground to top of sign 23 ft
12. Illumination: ☐ None ☐ External ☑ Internal (NOT permitted in CVP, IS, UT or any Residential Zones)
13. Does sign project over public property or sidewalk? ☐ Yes* ☑ No
    *By how much? _____
    How far back is leading edge of sign from any curb face? _____

NOTE: Any applicant for a permit to locate a projecting sign over a public right-of-way, in accordance with this Ordinance, shall file with the Code Administrator, a certificate of insurance indemnifying the City of Concord against any form of liability in a minimum amount as specified by the Finance Director. No permit shall be issued prior to the receipt of said certificate and the permit shall be valid only so long as the certificate remains in effect. The policy shall provide for advanced notification to the Code Administrator in the event of cancellation. If the policy should lapse or be cancelled, the applicant shall remove the sign immediately. (Article 28-6-11.a)

14. Does the sign require Design Review? ☑ *Yes ☐ No ☐ Historical District Review? ☐ Yes ☐ No

*Design Review is ***required*** per Article 28-6-9.f, if any of the following apply:

i. The sign is to be located in a Performance District;
ii. The development requires Major Site Plan Review, Article 28-9-4.d.1;
iii. The sign area is greater than the maximum in column 1 of Table 28-6-9.a;
iv. The sign is the second or third freestanding sign on a lot.

JARED

JAMES ALLEN

Store 2443

PATRIOTS PLACE
297 LOUDON ROAD
CONCORD, NH 03301

Ruggles SIGN

93 Industry Drive
PO Box 349
Versailles, KY 40383
859.879.1199

WSA MEMBER

JARED

Store 2443

PATRIOTS PLACE
297 LOUDON ROAD
CONCORD, NH 03301

This sign is intended to be installed in accordance with the requirements of Article 600 of the National Electrical Code and/or other applicable local codes. This includes proper grounding and bonding of the sign.

RUGGLES SIGN DOES NOT PROVIDE PRIMARY ELECTRICAL TO SIGN LOCATION!

c UL us

Submittal Date: 08/24/20 JW
Acct Rep: Cory Zagaruyka
Designer: Derek Couch

REVISIONS

r1: _____ r7: _____
r2: _____ r8: _____
r3: _____ r9: _____
r4: _____ r10: _____
r5: _____ r11: _____
r6: _____ r12: _____

EXISTING SIGNAGE - STOREFRONT ELEVATION
Scale: N.T.S.

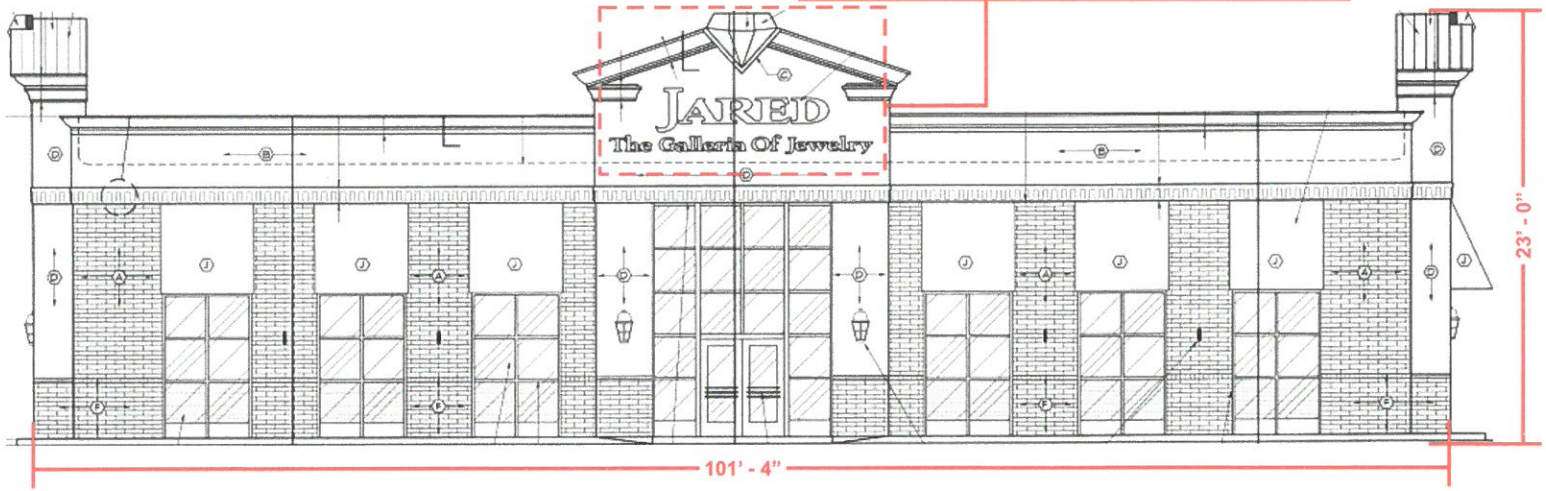

PROPOSED NEW SIGNAGE - STOREFRONT ELEVATION
Scale: N.T.S.

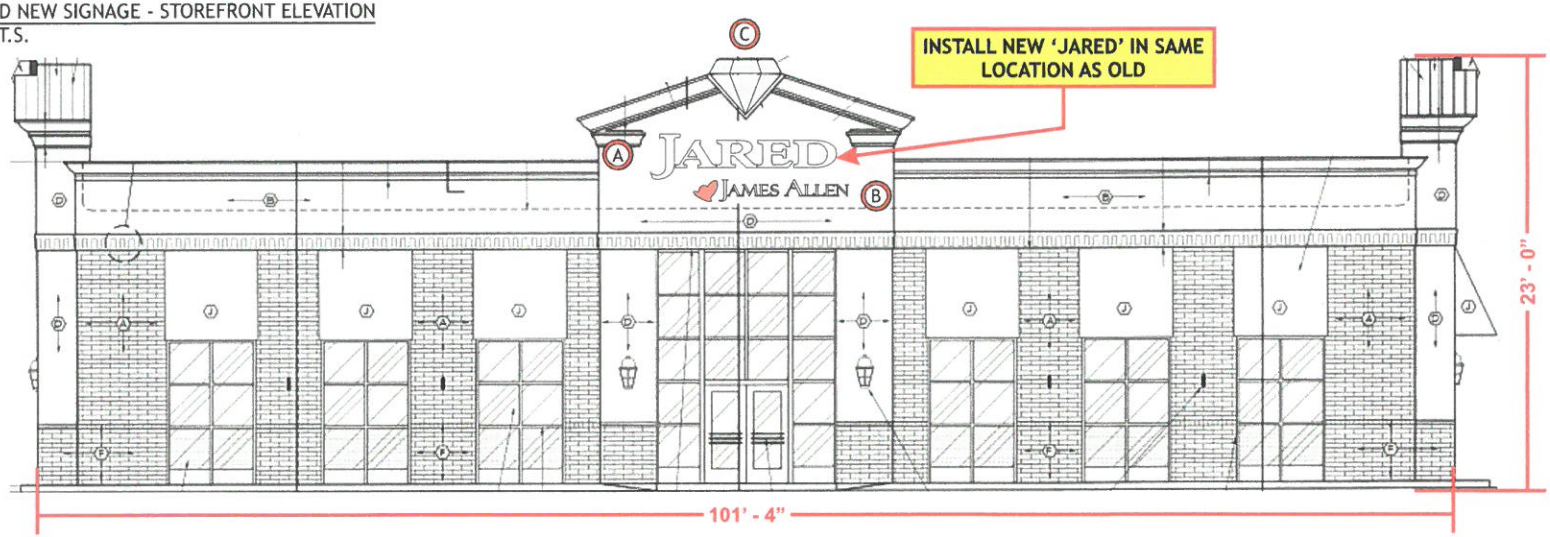

A J37.125FL Qty - 1

B JJA18FL Qty - 1

C J DIA60 rec Qty - 1

Ruggles SIGN

93 Industry Drive
PO Box 349
Versailles, KY 40383
859.879.1199

WSA IA MEMBER MSA

JARED

Store 2443

PATRIOTS PLACE
297 LOUDON ROAD
CONCORD, NH 03301

This sign is intended to be installed in accordance with the requirements of Article 600 of the National Electrical Code and/or other applicable local codes. This includes proper grounding and bonding of the sign.

RUGGLES SIGN DOES NOT PROVIDE PRIMARY ELECTRICAL TO SIGN LOCATION!

c UL us

Submittal Date: 08/24/20 JW
Acct Rep: Cory Zagaruyka
Designer: Derek Couch

REVISIONS

r1: r7:
r2: r8:
r3: r9:
r4: r10:
r5: r11:
r6: r12:

(A) FACE-LIT CHANNEL LETTERS - ELEVATION
Scale: 3/8" = 1' - 0"

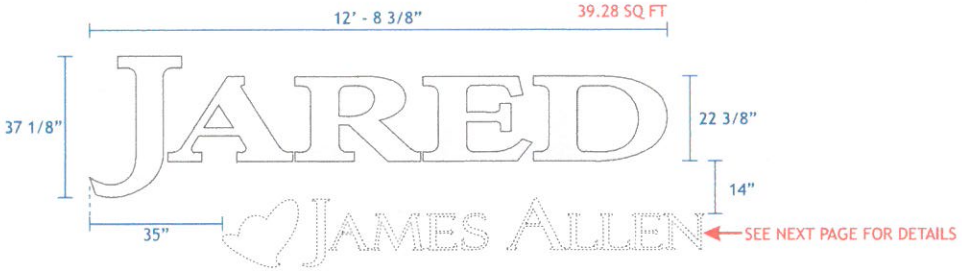

FACE-LIT CHANNEL LETTERS - SECTION
Scale: 1 1/2" = 1' - 0"

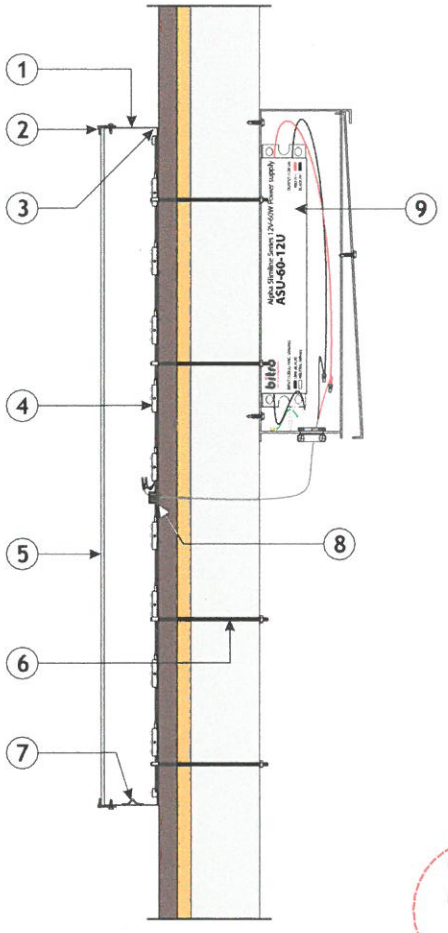

SIGN - DETAILS

1. 3" DEEP x .040 ALUMINUM LETTER RETURNS PAINTED BLACK CHERRY (SW #GF5-95955) ON EXTERIOR SURFACES, INTERIOR SURFACES PAINTED HIGH GLOSS WHITE
2. 1" BLACK CHERRY TRIM CAP SECURED TO LETTER RETURN WITH SMALL SELF -TAPPING SCREW, PAINTED TO MATCH TRIM CAP
3. LETTER RETURNS ARE CLINCHED TOGETHER TO .063 ROUTED ALUMINUM BACKS AROUND THE ENTIRE PERIMETER OF LETTER
4. BITRO OPTICSPRO LITE 6500k WHITE LED UNITS
5. 3/16" THICK, ROUTED #7328 WHITE ACRYLIC LETTER FACES
6. 10-24 RIVET NUT, WITH 3/16" ALL THREAD ROD AND 10-24 WIZ NUT FASTENERS BEHIND WALL
7. DRAIN HOLE IN BOTTOM OF LETTER RETURN WITH LIGHT COVER
8. (1) HEYCO GROMMET PER LETTER FOR LOW VOLTAGE PASS THRU
9. BITRO ASU-60-12U LED DRIVER (120-277 VOLT) CONTAINED IN PAIGE 980054C SNAP 2 ENCLOSURE BEHIND WALL

DEDICATED PRIMARY SIGN CIRCUIT AND DISCONNECT PROVIDED BY ELECTRICIAN

J37.125FL

Ruggles SIGN
93 Industry Drive
PO Box 349
Versailles, KY 40383
859.879.1199

MEMBER

JARED

Store 2443

PATRIOTS PLACE
297 LOUDON ROAD
CONCORD, NH 03301

This sign is intended to be installed in accordance with the requirements of Article 600 of the National Electrical Code and/or other applicable local codes. This includes proper grounding and bonding of the sign.

RUGGLES SIGN DOES NOT PROVIDE PRIMARY ELECTRICAL TO SIGN LOCATION!

Suitable for Wet Locations

UL label located on top of signs

Submittal Date: 08/24/20 JW
Acct Rep: Cory Zagaruyka
Designer: Derek Couch

REVISIONS

r1: r7:
r2: r8:
r3: r9:
r4: r10:
r5: r11:
r6: r12:

(B) FACE-LIT CHANNEL LETTERS - ELEVATION
Scale: 1/2" = 1' - 0"

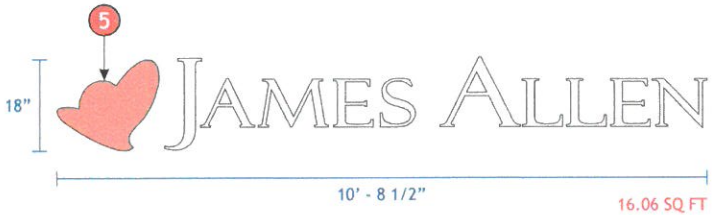

FACE-LIT CHANNEL LETTERS - SECTION
Scale: 1 1/2" = 1' - 0"

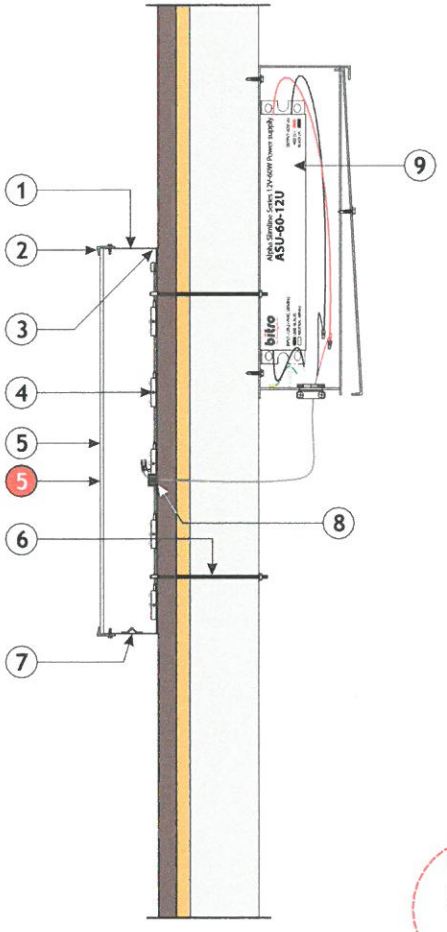

SIGN - DETAILS

1. 3" DEEP x .040 ALUMINUM LETTER RETURNS PAINTED BLACK CHERRY (SW #GF5-95955) ON EXTERIOR SURFACES, INTERIOR SURFACES PAINTED HIGH GLOSS WHITE
2. 1" TRIM CAP PAINTED TO MATCH RETURNS SECURED TO LETTER RETURN WITH SMALL SELF -TAPPING SCREW, PAINTED TO MATCH TRIM CAP
3. LETTER RETURNS ARE CLINCHED TOGETHER TO .063 ROUTED ALUMINUM BACKS AROUND THE ENTIRE PERIMETER OF LETTER
4. BITRO OPTICSPRO LITE 6500k WHITE LED UNITS
5. 3/16" THICK, ROUTED #7328 WHITE ACRYLIC LETTER FACES
5. 3/16" THICK, ROUTED #7328 WHITE ACRYLIC ICON FACE WITH TRANSLUCENT VINYL APPLIED TO FACE, VINYL TO MATCH PMS #177C, 3/4" TRIM CAP SECURED TO LETTER WITH SELF TAPPING SCREW (TO MATCH RETURNS)
6. 10-24 RIVET NUT, WITH 3/16" ALL THREAD ROD AND 10-24 WIZ NUT FASTENERS BEHIND WALL
7. DRAIN HOLE IN BOTTOM OF LETTER RETURN WITH LIGHT COVER
8. (1) HEYCO GROMMET PER LETTER FOR LOW VOLTAGE PASS THRU
9. BITRO ASU-60-12U LED DRIVER (120-277 VOLT) CONTAINED IN PAIGE 980054C SNAP 2 ENCLOSURE BEHIND WALL

DEDICATED PRIMARY SIGN CIRCUIT AND DISCONNECT PROVIDED BY ELECTRICIAN

JJA18FL

Ruggles SIGN
93 Industry Drive
PO Box 349
Versailles, KY 40383
859.879.1199

WSA ISA MEMBER NSA

JARED

Store 2443

PATRIOTS PLACE
297 LOUDON ROAD
CONCORD, NH 03301

This sign is intended to be installed in accordance with the requirements of Article 600 of the National Electrical Code and/or other applicable local codes. This includes proper grounding and bonding of the sign.

RUGGLES SIGN DOES NOT PROVIDE PRIMARY ELECTRICAL TO SIGN LOCATION!

c UL us Suitable for Wet Locations

UL label located on top of signs

Submittal Date: 08/24/20 JW
Acct Rep: Cory Zagaruyka
Designer: Derek Couch

REVISIONS

r1: r7:
r2: r8:
r3: r9:
r4: r10:
r5: r11:
r6: r12:

Portsmouth St
Old Loudon Rd
Loudon Rd
311
313
65
306
51
299
297
295
289
296
313
317
321
327
310